Telephone: 860-435-5190 Fax: 860-435-5172 Email: landuse@salisburyct.us



Town Hall P.O. Box 548 27 Main Street Salisbury, Connecticut 06068

July 31, 2024

Aaron & Alycia Zimmerman 52 Dean Street Apt 5D Brooklyn, NY 11201

RE: Observation of Potential Violation - 16 Woodland Drive, Lakeville

Dear Property Owner,

It has come to the attention of the Land Use Office that the above referenced property appears to be in violation of Town Land Use Regulations.

## DETAILS:

The property known as 16 Woodland Drive is in the RR-1 residential zone. In 2022, a variance and Inland Wetlands & Watercourses Commission permit for regulated activity were granted for an addition to a nonconforming single-family residence. Additionally, a Special Permit was granted for vertical expansion of a non-conforming single-family residence. Due to proximity to wetlands, the approved site plan included planting of a vegetative buffer between the house and wetlands. On January 19, 2024 the Building Official conducted a final inspection and the final building permit fee was paid in anticipation of a Certificate of Occupancy. To date, a Certificate of Zoning Compliance (a requirement of Certificate of Use/Occupancy) has NOT been issued for the use/occupancy of the structure. Therefore, occupancy of the dwelling is not permitted. Additionally, it appears that the building encroaches 4.9' closer to the front property line than was originally approved by the Zoning Board of Appeals when a variance for relief from the front yard setback was granted.

## SECTION: 910 and 910.5

910 No building or structure or structural alteration hereafter erected shall be occupied or used, in whole or in part, for any purpose until a Zoning Certificate of Compliance shall have been issued by the Zoning Administrator stating that the premises or building complies with all the provisions of these Regulations.

## 910.5 Conditional Zoning Certificate of Compliance

When the required site work cannot be completed because of inclement weather or other pertinent reasons, a Conditional Zoning Certificate of Compliance may be issued by the Zoning Administrator for a period not to exceed six (6) months provided that the applicant shall post a bond in accordance with the requirements of these Regulations to guarantee satisfactory completion of the site work in accordance with the approved Zoning Permit, including Special Permit and/or Site Plan, as determined by the Zoning Administrator. Upon satisfactory completion of the site work, the Zoning Administrator shall release the bond, subject to approval of the Commission.

Telephone: 860-435-5190 Fax: 860-435-5172 Email: landuse@salisburyct.us



Town Hall P.O. Box 548 27 Main Street Salisbury, Connecticut 06068

This letter is to notify you of the potential violation(s) occurring on the above captioned property. Be advised this is NOT a Cease-and-Desist Order. However, failure to provide information and/or remedy this situation within 30 days of this letter's date may lead to the issuance of such an order. As this is a request for information/remedy, this does not constitute a decision by the Land Use Administrator and/or the Commission, and therefore does not constitute an appealable action.

Please address the items in the checked boxes below:

⊠Contact the Land Use Administrator at <u>aconroy@salisburyct.us</u> to schedule an appointment to discuss the matter within 30 days of the date of this notice.

☐Immediately install erosion controls and stabilize exposed soils following Best Management Practices (BMPs) to prevent potential damage to natural resources and neighboring properties.

☐Complete the relevant enclosed application(s) and submit with any supporting materials to the Land Use Office

Your anticipated cooperation in this matter is greatly appreciated.

Sincerely,

Abby Conroy

Zoning Administrator

CC:

Michael Carbone, Building Official Cathy Weber, TAHD Sanitarian


Telephone: 860-435-5190 Fax: 860-435-5172 Email: landuse@salisburyct.us



Town Hall P.O. Box 548 27 Main Street Salisbury, Connecticut 06068

As Built May 6, 2024


# WOODLAND DRIVE

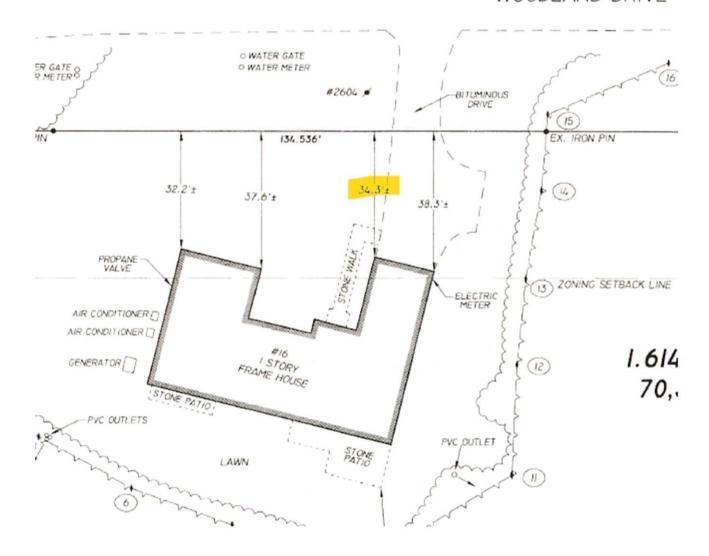

Telephone: 860-435-5190 Fax: 860-435-5172 Email: landuse@salisburyct.us



Town Hall P.O. Box 548 27 Main Street Salisbury, Connecticut 06068

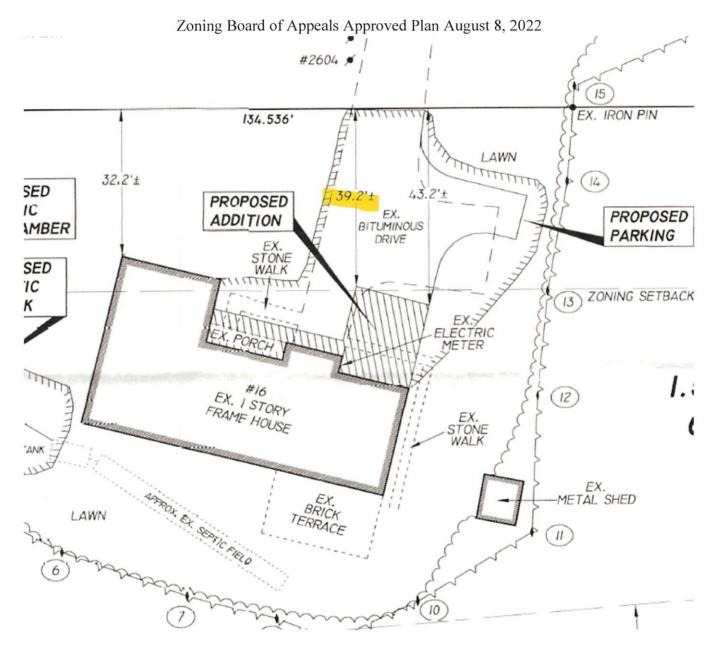


Telephone: 860-435-5190 Fax: 860-435-5172 Email: landuse@salisburyct.us



Town Hall P.O. Box 548 27 Main Street Salisbury, Connecticut 06068

Inland Wetlands & Watercourses Commission and Planning & Zoning Commission Approved Plan Revised 8/25/2022

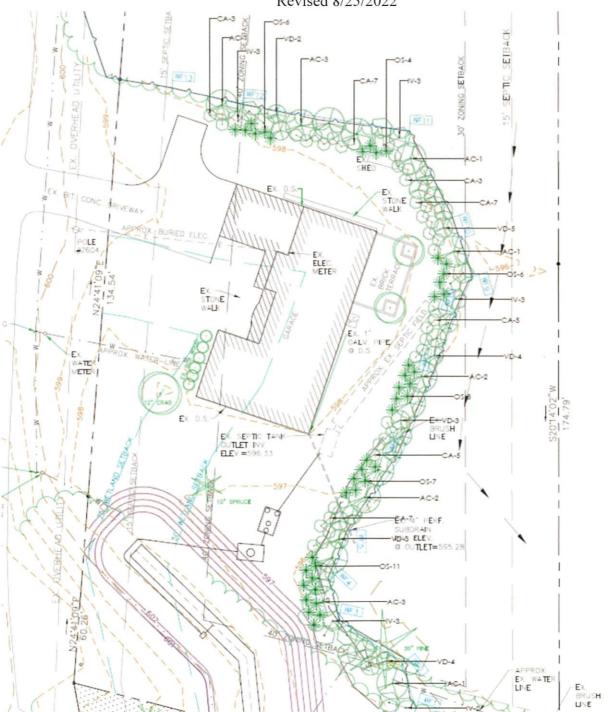

Telephone: 860-435-5190 Fax: 860-435-5172 Email: landuse@salisburyct.us



Town Hall P.O. Box 548 27 Main Street Salisbury, Connecticut 06068

## PLANT SCHEDULE

SYM	BOTANICAL-NAME	COMMON-NAME	SIZE	ROOT	QTY
SHR	UBS				
AC	Amelanchier canadesnsis	Shadblow FAC	3'-4' Ht	Cont	13
CA	Clethra alnifolia	Sweet Pepperbush- FAC+	2"-3" Ht	Cont	37
IV	Ilex verticillata	Winterberry - FACW	18"-24"	Cont	14
VD	Viburnum dentatum	Northern Arrowwood Viburnum - FACW	2'-3' Ht	Cont	21
HER	BACEOUS PLANTS				
os	Onoclea sensibilis	Sensitive Fern FACW		1 Gal.	42