

Torrington Area Health District
350 Main St. - Suite A; Torrington, Ct 06790

Permit #

18420

T A H D Is A Equal Opportunity Provider
Design Review For
Subsurface Sewage Disposal System

62	Rocky Lane	Salisbury	Main House			
Lot #	Street #	Street Name	Town	Subdivision		
Jeffrey S. Bravin	37	Braintree Dr	West Hartford	Ct.	06117	
Owner		Owner Address	Town	State	Zip	

Owner Telephone	Agent's Name				
Allied Engineering	Po Box 726	N. Canaan	Ct.	06018	
Engineer	Engineer Address	Town	State	Zip	

This Approval Indicates That The Proposal Has Been Reviewed By The Health District And Is In Compliance With Applicable Regulations As Contained In The Public Health Code For This Project.

Plan Date: July 17, 2026

Plan prepared by George Johannesen

Plan Approval Date: July 30, 2026

Of Bedrooms: 6

12" Geomatrix 6212	1500	1040	104'	
Septic System Type	Tank Size	Field Sq Ft.	Length Of Septic System	

☒ Approved	☐ Plan Revision Required	☒ Required	☐ Not Required
(2) Perk Tests In Fill By Engineer			

This Is Not A Permit To Construct A Subsurface Sewage Disposal System. The Permit To Construct Will Be Issued To The Licensed Septic System Installer Prior To Actual Construction. This Plan Approval Is Subject To Specific And General Conditions As Shown On This Form And/or The Approved Plan. **Please Read Them Carefully.**

☒ Engineer Design	☒ Select Fill Required	☒ As Below
☒ Percolation Test In Fill	☐ Curtain Drain	☒ In Place Sieve Test Required
☒ Engineer As Built Required	☐ Engineer Supervision	☐ Low Flow Water Treatment
☒ Field Staking By Engineer	☐ As-built Installer	

6 bedroom repair system. Floor plans approved 7/7/26.

- No Free-draining material "FDM" on electrical line within 25' of leach field.
- Call TAHD for scarification inspection; submit supplier sieve prior placement of c33.
- P.E. in-place sieve required.
- Notify PE/TAHD immediately if there are any deviations from this plan.
- TAHD/PE final inspections; PE as-built.

See additional PE & TAHD notes on plan.

Approved By: _____

Director Of Health


Sanitarian

Torrington Area Health District
350 Main St. - Suite A; Torrington, Ct 06790

Permit #

18525

T A H D Is A Equal Opportunity Provider
Design Review For
Subsurface Sewage Disposal System

62	Rocky Lane	Salisbury	Guest House
Lot #	Street # Street Name	Town	Subdivision
Jeffrey & Naomi Bravin	P. O. Box 2	Taconic	Ct. 06079
Owner	Owner Address	Town	State Zip
not given			
Owner Telephone		Agent's Name	
Allied Engineering	Po Box 726	N. Canaan	Ct. 06018
Engineer	Engineer Address	Town	State Zip

This Approval Indicates That The Proposal Has Been Reviewed By The Health District And Is In Compliance With Applicable Regulations As Contained In The Public Health Code For This Project.

Plan Date: July 17, 2026

Plan prepared by George Johannesen

Plan Approval Date: July 30, 2026

Of Bedrooms: 4

Geomatrix Gst 6212	1250	800	80'
Septic System Type	Tank Size	Field Sq Ft.	Length Of Septic System

☒ Approved	☐ Plan Revision Required	☒ Required ☐ Not Required
(2) Perk Tests In Fill By Engineer		

This Is Not A Permit To Construct A Subsurface Sewage Disposal System. The Permit To Construct Will Be Issued To The Licensed Septic System Installer Prior To Actual Construction. This Plan Approval Is Subject To Specific And General Conditions As Shown On This Form And/or The Approved Plan. **Please Read Them Carefully.**

☒ Engineer Design	☒ Select Fill Required	☒ As Below
☒ Percolation Test In Fill	☐ Curtain Drain	☒ In Place Sieve Test Required
☒ Engineer As Built Required	☐ Engineer Supervision	☐ Low Flow Water Treatment
☒ Field Staking By Engineer	☐ As-built Installer	

Proposed 3-bedroom house, sized 4. New system. Floor plans approved 7/7/26.

- PE stake entire system, drainage, utility lines and other critical components.
- Avoid joints where water & sewer lines connect.
- Maintain adequate separation distances, including proposed rain gardens to system and water supply well.
- Call TAHD for scarification inspection; submit supplier sieve prior placement of c33.
- P.E. in-place sieve required.
- Notify PE/TAHD immediately if there are any deviations from this plan.
- TAHD/PE final inspections; PE as-built.

See additional PE & TAHD notes on plan.

Approved By: _____

Director Of Health


Sanitarian

SITE INFORMATION

TAX MAP DESIGNATION:
TOWN OF SALESBURY
MAP 66, LOT 27
VOL. 275 PG. 361
STREET ADDRESS:
62 ROCKY LANE
SALESBURY, CT 06068
USE:
EXISTING: RESIDENTIAL
ZONED: RR1

PROPERTY OWNER:
JEFFREY AND NAOMI A. BRAVIN
WESLEY MILLER & LINDA WILLIAMS
PO BOX 2
TACONIC, CT 06079

APPLICANT:
ALLIED ENGINEERING ASSOC., INC.
95 MAIN ST
CANAN, CONNECTICUT 06018
PH # (860) 824-1400

PROPOSED: RESIDENTIAL

ZONING DATA

NC = NO CHANGE
NR = NO REGULATION

DIMENSIONAL REQUIREMENTS

	EXISTING	PROPOSED	ALLOWED/REQUIRED
LOT AREA	160,343 SF	160,343 SF	80,000 SF MIN.
BUILDABLE AREA	20,000 SF	20,000 SF	20,000 SF MIN
STREET FRONTAGE	501.7'	501.7'	25 FT MIN.
FRONT YARD SETBACK	159.9'	126.0'	40 FT. MIN.
SIDE YARD SETBACK	161.7'	64.5'	30 FT. MIN.
REAR YARD SETBACK	185.7'	55.9'	30 FT. MIN.
MIN. SQUARE	150'	150'	150'
BUILDING COVERAGE	0.53%	3.96%	10% MAX.
BUILDING HEIGHT	20'	30'	35' MAX.
SEPARATION BETWEEN BUILDINGS	N/A	N/A	10' MIN
SEPARATION FROM WATERCOURSE	N/A	N/A	75' MIN.

NOTES

- REFERENCE MAPS:
B100A SKETCH PLAN PREPARED FOR RICHARD VERMILLION
62 ROCKY LANE, SALESBURY, CONNECTICUT PREPARED BY
BERKSHIRE ENGINEERING & SURVEYING, LLC
DATED 9-16-15 SCALE: 1"=20'
- IMPROVEMENT LOCATION SURVEY - PROPOSED: 62 ROCKY LANE,
SALESBURY, CONNECTICUT PREPARED FOR RICHARD C. VERMILLION PREPARED BY
DAVID A. HUGHES PROFESSIONAL ENGINEER AND LAND SURVEYOR
DATED TO 03/04/19 SCALE: 1"=10'
- ALL EXISTING SITE FEATURES SHALL REMAIN AS IS UNLESS NOTED
ON DRAWINGS.
- STATE LAW REQUIRES: CALL BEFORE YOU DIG 1-800-922-4455 TO VERIFY THE
LOCATION OF UNDERGROUND UTILITIES.
- UTILITY INFORMATION SHOWN IS TAKEN FROM UTILITY COMPANY MAPS, OTHER MAPS,
AND LIMITED FIELD SURVEY. CONTRACTOR IS RESPONSIBLE FOR FINAL VERIFICATION
OF UTILITY LOCATIONS AFFECTING THE PROPOSED WORK. ANY DISCREPANCY
BETWEEN THE PLANS AND ACTUAL FIELD CONDITIONS ARE TO BE BROUGHT TO THE
ATTENTION OF THE DESIGN ENGINEER, THE OWNER, AND THE TOWN ENGINEER.
NO CHANGES TO THE PROPOSED CONSTRUCTION CAN BE MADE WITHOUT PRIOR
APPROVAL.
- ANY ADDITIONAL EROSION/SEDIMENTATION CONTROL METHODS DEEMED NECESSARY BY TOWN
STAFF SHALL BE IMPLEMENTED BY THE CONTRACTOR AT HIS OWN EXPENSE.
- ANY EXISTING WORK OR SITE DRAINAGE STRUCTURES OR UTILITIES, OTHER THAN THOSE
CALLED OUT TO BE REPLACED OR MODIFIED, WHICH ARE DAMAGED BY THE CONTRACTOR
DURING CONSTRUCTION, SHALL BE REPLACED AT THE CONTRACTOR'S
EXPENSE.
- ALL CONSTRUCTION AND EXCAVATION PROCEDURES TO BE IN ACCORDANCE WITH
STANDARD CONSTRUCTION PRACTICES.
- ANY REFUSE OR DEBRIS MUST BE PROPERLY DISPOSED OF DAILY AT THE CONTRACTOR'S EXPENSE.
- ELEVATIONS ARE BASED ON REFERENCED SURVEYS

RAINGARDEN SIZING
MAIN HOUSE ROOF AREA = 2,731 SF
GUEST HOUSE ROOF AREA = 2,185 SF
RAIN GARDEN #1
2,731 SF x .033 FT RAIN = 227 CU. FT. REQ'D
260' CONTOUR AREA = 562 SF
258' CONTOUR AREA = 110 SF
VOLUME PROVIDED = 336 CU FT
RAIN GARDEN #2
2,185 SF x .033 FT = 181 CU. FT. REQ'D
276' CONTOUR AREA = 522 SF
274' CONTOUR AREA = 105 SF
VOLUME PROVIDED = 313 CU FT
SEED WITH NEW ENGLAND WETLAND PLANTS
NEW ENGLAND EROSION CONTROL/RESTORATION SEED MIX

LEGEND


- STONE WALL
- WIRE FENCE
- NO PHYSICAL BOUNDARY
- DECIDUOUS TREE
- CONIFEROUS TREE
- FOLIAGE LINE
- FENCE
- CATCH BASIN
- WETLAND BOUNDARY
- EXISTING CONTOUR
- PROPOSED CONTOUR
- SILT FENCE
- PROPOSED SPOT ELEVATION
- APPROX. LIMIT OF DISTURBED AREA
- TO BE REMOVED
- EXISTING
- GRADE TO DRAIN
- OBSERVATION PIT and/or PERCOLATION HOLE.

APPROVED.
30
7-27-26
Data Book 9-20-26 - REV.
Reviewed: B. [Signature]
Permit # 15426
Scanned 7-27-26

PROPOSED OVERALL SITE PLAN

SCALE: 1"=20'
FILE NAME: 1127-SITE-16
DATE: 5/26/26
ISSUED FOR: PERMITTING
PROJECT NO. 1127
DRAWING NO. C-1

REVISIONS
NUMBER DESCRIPTION DATE INITIAL
1. - MOVED MAIN HOUSE 25' NORTH - 7/01/26 - GHJ
2. - REV. PER TAND - 7/17/26 - GHJ

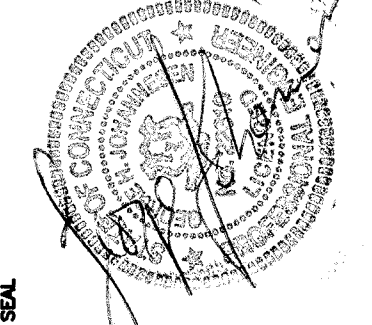

ALLIED Engineering Assoc. Inc.
95 Main St. 3rd Fl. East
P.O. Box 7000
Canan, CT 06018
860-824-1400
860-824-1401 fax
aca.george@gmail.com


INSTALLERS COPY

SITE INFORMATION


TAX MAP DESIGNATION: TOWN OF SALISBURY MAP 5-3, BLOCK 82, LOT 10 VOL. 53 PG. 224 STREET ADDRESS: 62 ROCKY LANE SALISBURY, CT 06068
PROPERTY OWNER: JEFFREY AND NAOMI BRAVIN PO BOX 2 TACONIC, CT 06079
APPLICANT: TACALA NORTH, INC. 99 RAINBOW ROAD EAST GRANBY, CONNECTICUT 06026 Ph # (860) 653-2810
USE: EXISTING: RESIDENTIAL PROPOSED: RESIDENTIAL
ZONED: RR1

GENERAL NOTES

- TOPOGRAPHY, PROPERTY LINES, DIMENSIONS AND MISCELLANEOUS INFORMATION TAKEN FROM:
 - "IMPROVEMENT LOCATION SURVEY-PROPOSED, 62 ROCKY LANE, SALISBURY, CT, PREPARED FOR MR. RICHARD VERMILLION, III" DATE 02/18/19 SCALE: 1"=30', BY DAVID A. HUGHES PROFESSIONAL ENGINEER & LAND SURVEYOR
 - "B1000 SKETCH PLAN PREPARED FOR RICHARD VERMILLION, 62 ROCKY LANE, SALISBURY, CONNECTICUT" DATE 9-15-15, SCALE: 1"=20', BY BERKSHIRE ENGINEERING & SURVEYING, LLC.
- CONTRACTOR SHALL VERIFY ALL DIMENSIONS, ELEVATIONS AND SITE CONDITIONS PRIOR TO THE START OF CONSTRUCTION. POTENTIAL PROBLEMS OR CONFLICTS SHALL BE BROUGHT TO THE ATTENTION OF THE ENGINEER BEFORE CONSTRUCTION STARTS. THIS DESIGN IS SCHEMATIC, ADJUSTMENTS TO LOCATIONS, DIMENSIONS AND ELEVATIONS OF SEPTIC TANK AND LEACHING SYSTEM MAY BE NECESSARY TO CONFORM TO FIELD CONDITIONS. CHANGES IN THE DESIGN SHALL BE APPROVED BY THE LOCAL HEALTH DEPARTMENT. THE ENGINEER OR BOTH STATE LAW REQUIRES: CALL BEFORE YOU DIG 1-800-922-4455 TO VERIFY THE LOCATION OF UNDERGROUND UTILITIES.
- MATERIALS USED FOR THE JOB AND CONSTRUCTION PRACTICES SHALL BE IN ACCORDANCE WITH THE REQUIREMENTS OF THE LOCAL HEALTH DEPARTMENT AND/OR THE CONNECTICUT STATE DEPARTMENT OF HEALTH PUBLIC HEALTH CODE SECTION 19-13-B103 A-F.
- SEPTIC TANKS SHALL BE WATER TIGHT 1,500 GALLON AND 1,250 GALLON PRECAST CONCRETE, 2 COMPARTMENT TANKS OF LARGER. TANK SHALL BE PLACED LEVEL. TANK COVERS SHALL BE PLACED WITH NOTIFICATION THAT "ENTRANCE INTO THE TANK COULD BE FATAL". TANK COVERS SHALL BE EXTENDED TO GRADE WITH SUITABLE RISERS AS REQUIRED. A SECONDARY SAFETY DEVICE (SM/TECH STF-N24) IS REQUIRED INSIDE OF EACH TANK COVER. PROVIDE H-20 LOADING IF USED UNDER DRIVEWAY OR PARKING AREA. TANKS SHALL HAVE AN APPROVED NON-BYPASS EFFLUENT FILTER AT THE OUTLET. THE SEPTIC TANKS SHALL BE OF THE SIZE INDICATED AND SHALL BE PRECAST REINFORCED CONCRETE AS MANUFACTURED BY A. RICHARD SEPTIC SYSTEMS, INC., TORRINGTON, CONNECTICUT OR APPROVED EQUAL. IF A GARBAGE GRINDER IS INSTALLED IN THE HOUSE THE CAPACITY OF THE SEPTIC TANK SHALL BE INCREASED BY 250 GALLONS. IF LARGE TUB IS INSTALLED IN THE HOUSE, THE CAPACITY OF THE SEPTIC TANK SHALL BE INCREASED BY 250 GALLONS FOR A 100-200 GALLON TUB OR 500 GALLONS FOR A TUB OVER 200 GALLONS.
- PROVIDE 1"-3" MINIMUM COVER OVER SEPTIC TANK. TANKS INSTALLED IN DRIVE OR PARKING AREAS SHALL BE DESIGNED FOR H-20 LOADING.
- ALL PIPE USED SHALL CONFORM TO STATE OF CONNECTICUT, DEPARTMENT OF HEALTH STANDARDS AND SHALL HAVE 1"-0" MINIMUM COVER OVER TOP OF PIPE.
- THE PRECAST CONCRETE DISTRIBUTION BOX SHALL BE SET LEVEL TO PROVIDE EVEN FLOW TO BOTH SIDES. BOX SHALL BE SET ON 6" MIN. DEEP PAD OF COMPACTED GRAVEL OR 1" CRUSHED STONE.
- 6 BEDROOM SYSTEM**
THE SANITARY SEWAGE DISPOSAL SYSTEM CONSISTS OF 1 ROW GEOMATRIX GST 6212 FOR A TOTAL LENGTH OF 104 LF. 104 LF X 10 SF/LF=1,040 SF EFFECTIVE AREA PROVIDED. A 6 BEDROOM HOUSE REQUIRES 1,012.5 SF MIN LEACHING AREA.
- 4 BEDROOM SYSTEM**
THE SANITARY SEWAGE DISPOSAL SYSTEM CONSISTS OF 1 ROW GEOMATRIX GST 6212 FOR A TOTAL LENGTH OF 80 LF. 80 LF X 10 SF/LF=800 SF EFFECTIVE AREA PROVIDED. A 4 BEDROOM HOUSE REQUIRES 787.5 SF MIN LEACHING AREA.
- THE BACKFILL USED IN ALL SANITARY SEWAGE DISPOSAL SYSTEM TRENCHES SHALL BE AS SPECIFIED ON PLAN OR OTHER ACCEPTABLE MATERIAL MEETING THE SPECIFICATIONS OF THE STATE OF CONNECTICUT, DEPARTMENT OF HEALTH AND/OR LOCAL HEALTH DEPARTMENT.
- SURFACE WATER SHALL BE DIVERTED FROM THE SANITARY SEWAGE DISPOSAL SYSTEM AREA BY MEANS OF GRADING.
- THE DEVELOPER OR OWNER OR BOTH SHALL BE RESPONSIBLE FOR ALL RIGHTS OF WAYS AND RIGHTS TO DRAIN.
- NO SUBSURFACE INVESTIGATIONS WERE MADE OTHER THAN THOSE INDICATED. SUBSURFACE PROBLEMS ARE THE RESPONSIBILITY OF THE OWNER. THE EXACT LOCATIONS OF ANY UNDERGROUND UTILITIES ARE UNKNOWN AND ARE THE RESPONSIBILITY OF THE OWNER SHOULD ANY BE ENCOUNTERED DURING THE INSTALLATION OF THE SANITARY SYSTEM.
- THE SEPTIC SYSTEM IS FOR SANITARY SEWAGE DISPOSAL ONLY. ALL STORM WATER, COOLING WATER, WATER SOFTENER RESIDUES, SUBSOIL DRAINAGE AND OBJECTIONABLE INDUSTRIAL WASTES ARE TO BE EXCLUDED FROM THE SYSTEM.
- THE OWNER/CONTRACTOR SHALL BE RESPONSIBLE FOR OBTAINING ALL NECESSARY PERMITS PRIOR TO CONSTRUCTION.
- NO AIR CONDITIONING, REFRIGERATION, WATER SOFTENER RESIDUES, OR DRAINAGE (SURFACE OR SUBSURFACE) MAY BE CONNECTED TO THE SANITARY SEWAGE DISPOSAL SYSTEM.
- HOUSE FOOTING DRAINS SHALL BE KEPT 25' MIN. FROM ANY PART OF THE SANITARY SEWAGE DISPOSAL SYSTEM.
- REMOVE THE TOPSOIL IN THE AREA TO RECEIVE FILL. CARE SHALL BE TAKEN TO NOT OVERCOMPACT THE SOIL WITH HEAVY EQUIPMENT. KEEP HEAVY EQUIPMENT OFF OF THE EXPOSED SURFACE. EQUIPMENT SHALL NOT BE USED ON THE EXPOSED SURFACE AREA DURING MUDDY CONDITIONS.
- THERE ARE NO KNOWN WELLS WITHIN 75' OF THE PROPOSED SANITARY SEWAGE DISPOSAL SYSTEM.
- NO SUBSURFACE SEWAGE DISPOSAL SYSTEM SHALL BE CONSTRUCTED, ALTERED, REPAIRED OR EXTENDED WITHOUT AN APPROVAL TO CONSTRUCT ISSUED IN ACCORDANCE WITH THE CURRENT PUBLIC HEALTH CODE. NO DISCHARGE SHALL BE INITIATED TO A SUBSURFACE SEWAGE DISPOSAL SYSTEM WITHOUT A DISCHARGE PERMIT ISSUED IN ACCORDANCE WITH THE CURRENT PUBLIC HEALTH CODE. SUCH PERMITS AND APPROVALS SHALL BE ISSUED AND ADMINISTERED BY THE LOCAL DIRECTOR OF HEALTH.
- WHILE THE SEWAGE DISPOSAL SYSTEM IS UNDER CONSTRUCTION, THE LOCAL DIRECTOR OF HEALTH MAY REQUIRE THAT THE CONSTRUCTION BE SUPERVISED BY A PROFESSIONAL ENGINEER REGISTERED IN THE STATE OF CONNECTICUT, IF IN THE OPINION OF THE LOCAL DIRECTOR OF HEALTH IT IS NECESSARY TO INSURE CONFORMANCE TO THE PLANS APPROVED OR BECAUSE OF THE DIFFICULTIES LIKELY TO BE ENCOUNTERED. THE ENGINEER SHALL MAKE A RECORD DRAWING OF THE SEWAGE DISPOSAL SYSTEM, AS INSTALLED, WHICH HE SHALL SUBMIT TO THE LOCAL DIRECTOR OF HEALTH PRIOR TO THE ISSUANCE OF A DISCHARGE PERMIT.
- THERE ARE NO SOURCES OF CONTAMINATION WITHIN 75 FT. OF PROPOSED WELL SITE.
- THE SYSTEM MUST BE INSTALLED WHEN SOIL MOISTURE IS LOW.
- CONTRACTOR SHALL EXERCISE CAUTION WHEN WORKING ADJACENT TO TREES.
- "AN 'AS-BUILT' PLAN MUST BE PREPARED AND SUBMITTED TO THE LOCAL HEALTH DEPARTMENT, WITHIN 30 DAYS OF THE INSPECTION BY THE ENGINEER/SURVEYOR."
- "FOR LEACHING SYSTEMS CONSTRUCTED WITH THE BOTTOMS IN FILL, A MINIMUM OF TWO PERCOLATION TESTS MUST BE CONDUCTED IN THE FILL MATERIAL BEFORE THE LEACHING SYSTEM CAN BE INSTALLED."
- "NO BALLAST IS REQUIRED FOR THE SEPTIC TANK OR PUMP CHAMBER PROVIDED THAT A MINIMUM OF 1.25" OF COVER IS MAINTAINED."
- "AN IN-PLACE SIEVE TEST OF THE 'SELECT FILL' MATERIAL ON SITE TO BE CONDUCTED AS PART OF THE FILL APPROVAL PROCESS. THE TEST RESULTS FOR A COMPOSITE SAMPLE COLLECTED BY THE ENGINEER OR TESTING LAB MUST BE PROVIDED TO THE LOCAL HEALTH DEPARTMENT PRIOR TO ISSUANCE OF THE PERMIT TO DISCHARGE."

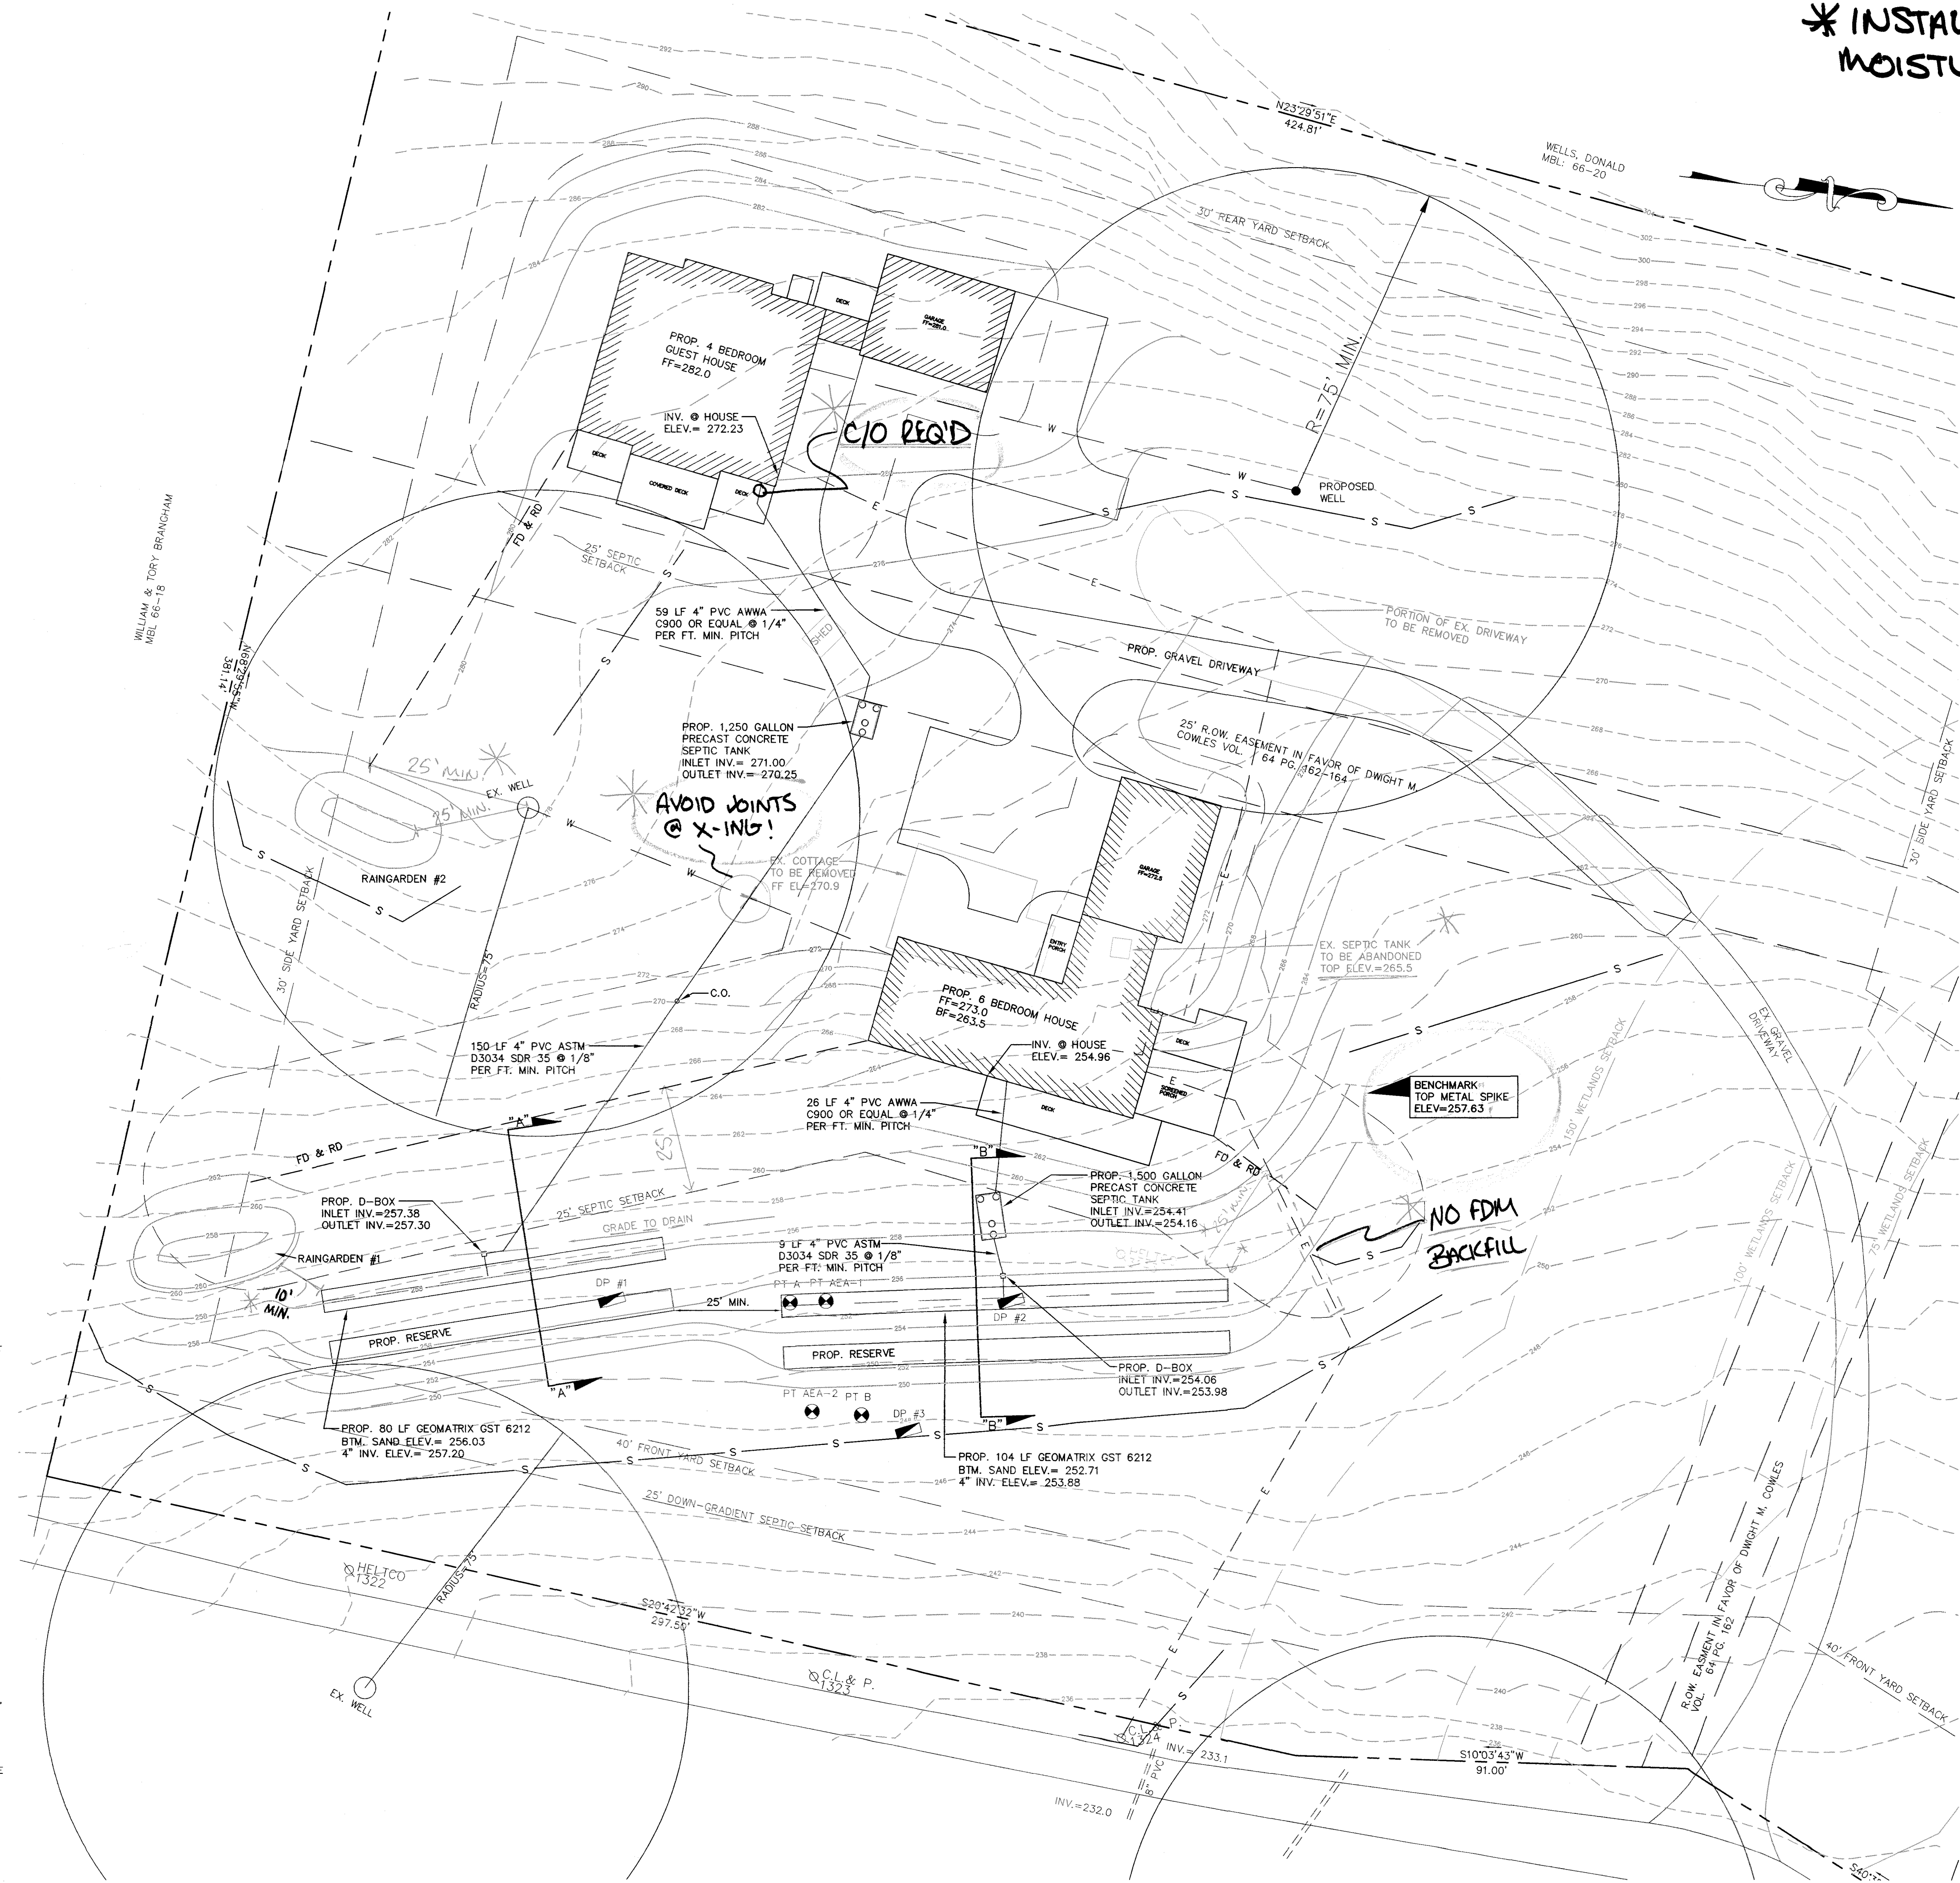

*INSTALL WHEN SOIL MOISTURE IS LOW!!

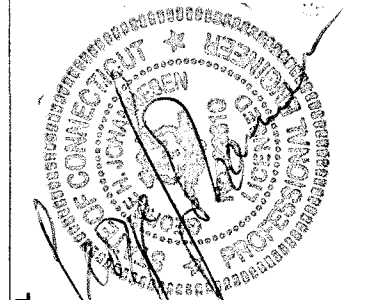

ALLIED ENGINEERING ASSOC. INC.
95 Main St. 3rd Fl. East
P.O. Box 726 North Granby, CT 06018
860-824-1401 Fax
nae.george@gmail.com

- REVISIONS
NUMBER DESCRIPTION DATE INITIAL
- REV. HOUSE LAYOUTS - 5/26/26 - GHJ
 - MOVED MAIN HOUSE 25' NORTH - 7/01/26 - GHJ
 - REV. PER TAND COMMENTS - 7/17/2026 - NAC

PROPOSED SANITARY SEWAGE DISPOSAL SYSTEM DESIGN PLAN
PREPARED FOR: JEFF BRAVIN

SCALE: 1"=20'
FILE NAME: 1127-SITE-16
DATE: 4/29/2026
ISSUED FOR: PERMITTING

PROJECT NO. 1127
DRAWING NO. C-2

62 ROCKY LANE
SALISBURY, CONNECTICUT

INSTALLER'S COPY


(MAIN)

TORRINGTON AREA HEALTH DISTRICT

Basis for Septic System
Dwelling Containing 6 Bedrooms
Commercial Building Discharging Gals/Day

7-7-26
Date

Signature

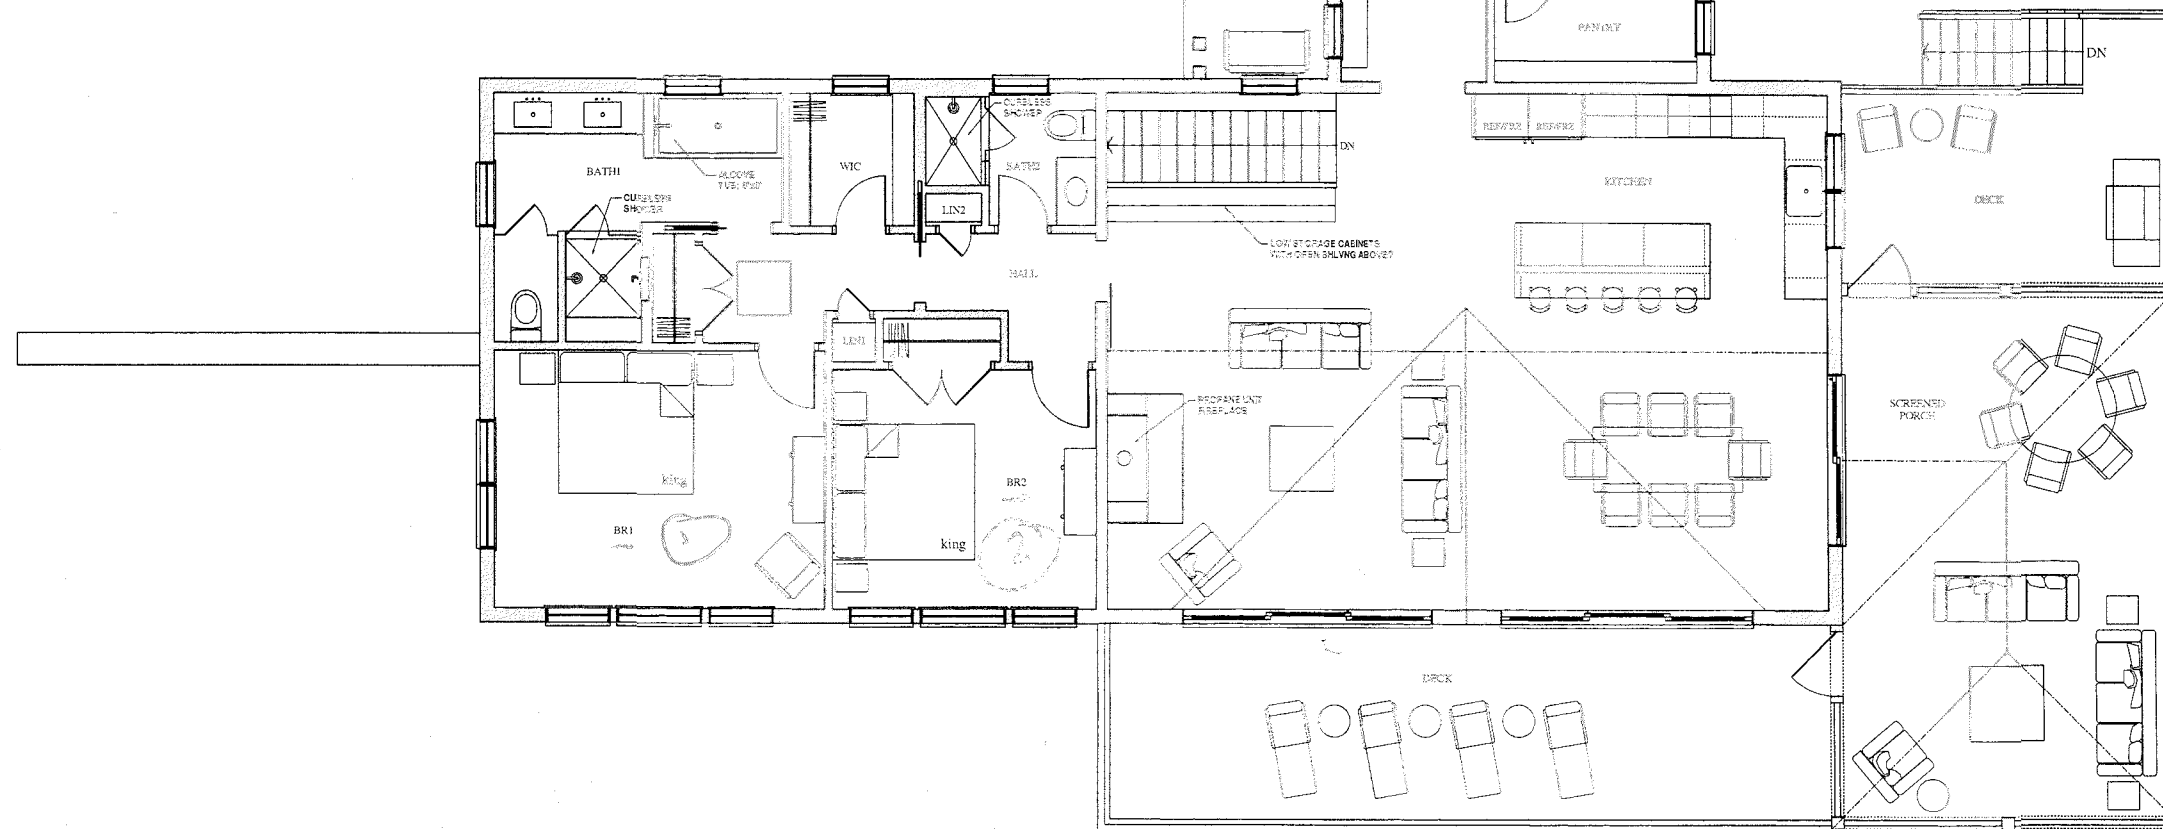

CONDITIONED FLOOR AREA	
MAIN FLOOR	1932 SF
LOWER LEVEL	1534 SF
TOTAL	3466 SF

AREA OF UNCONDITIONED SPACE:	
GARAGE	800 SF
ENTRY PORCH	100 SF
SCREENED PORCH	414 SF
DECKS	522 SF
TOTAL	1836 SF

PROPOSED DESIGN FOR

BRAVIN RESIDENCE & GUESTHOUSE

62 ROCKY LANE, TACONIC, CT

Elizabeth Slotnick
Architect
16 PROSPECT STREET
LAKEVILLE, CT 06039
860 435-1403
elizabethslotnick@gmail.com

Signature and Seal
Professional License # CT-ARI9437
Set Information
SCHEMATIC
DESIGN III
NOT FOR
CONSTRUCTION

Sheet Title
MAIN LEVEL
FLOOR PLAN

Date 04-03-26
Scale 1/4" = 1'-0"
Project No. BR26
Sheet No. A-1


(MAIN)

TORRINGTON AREA HEALTH DISTRICT

Basis for Septic System
Dwelling Containing 6 Bedrooms
Commercial Building Discharging - Gals/Day

Date 7-7-26

Signature *B. J. [Signature]*

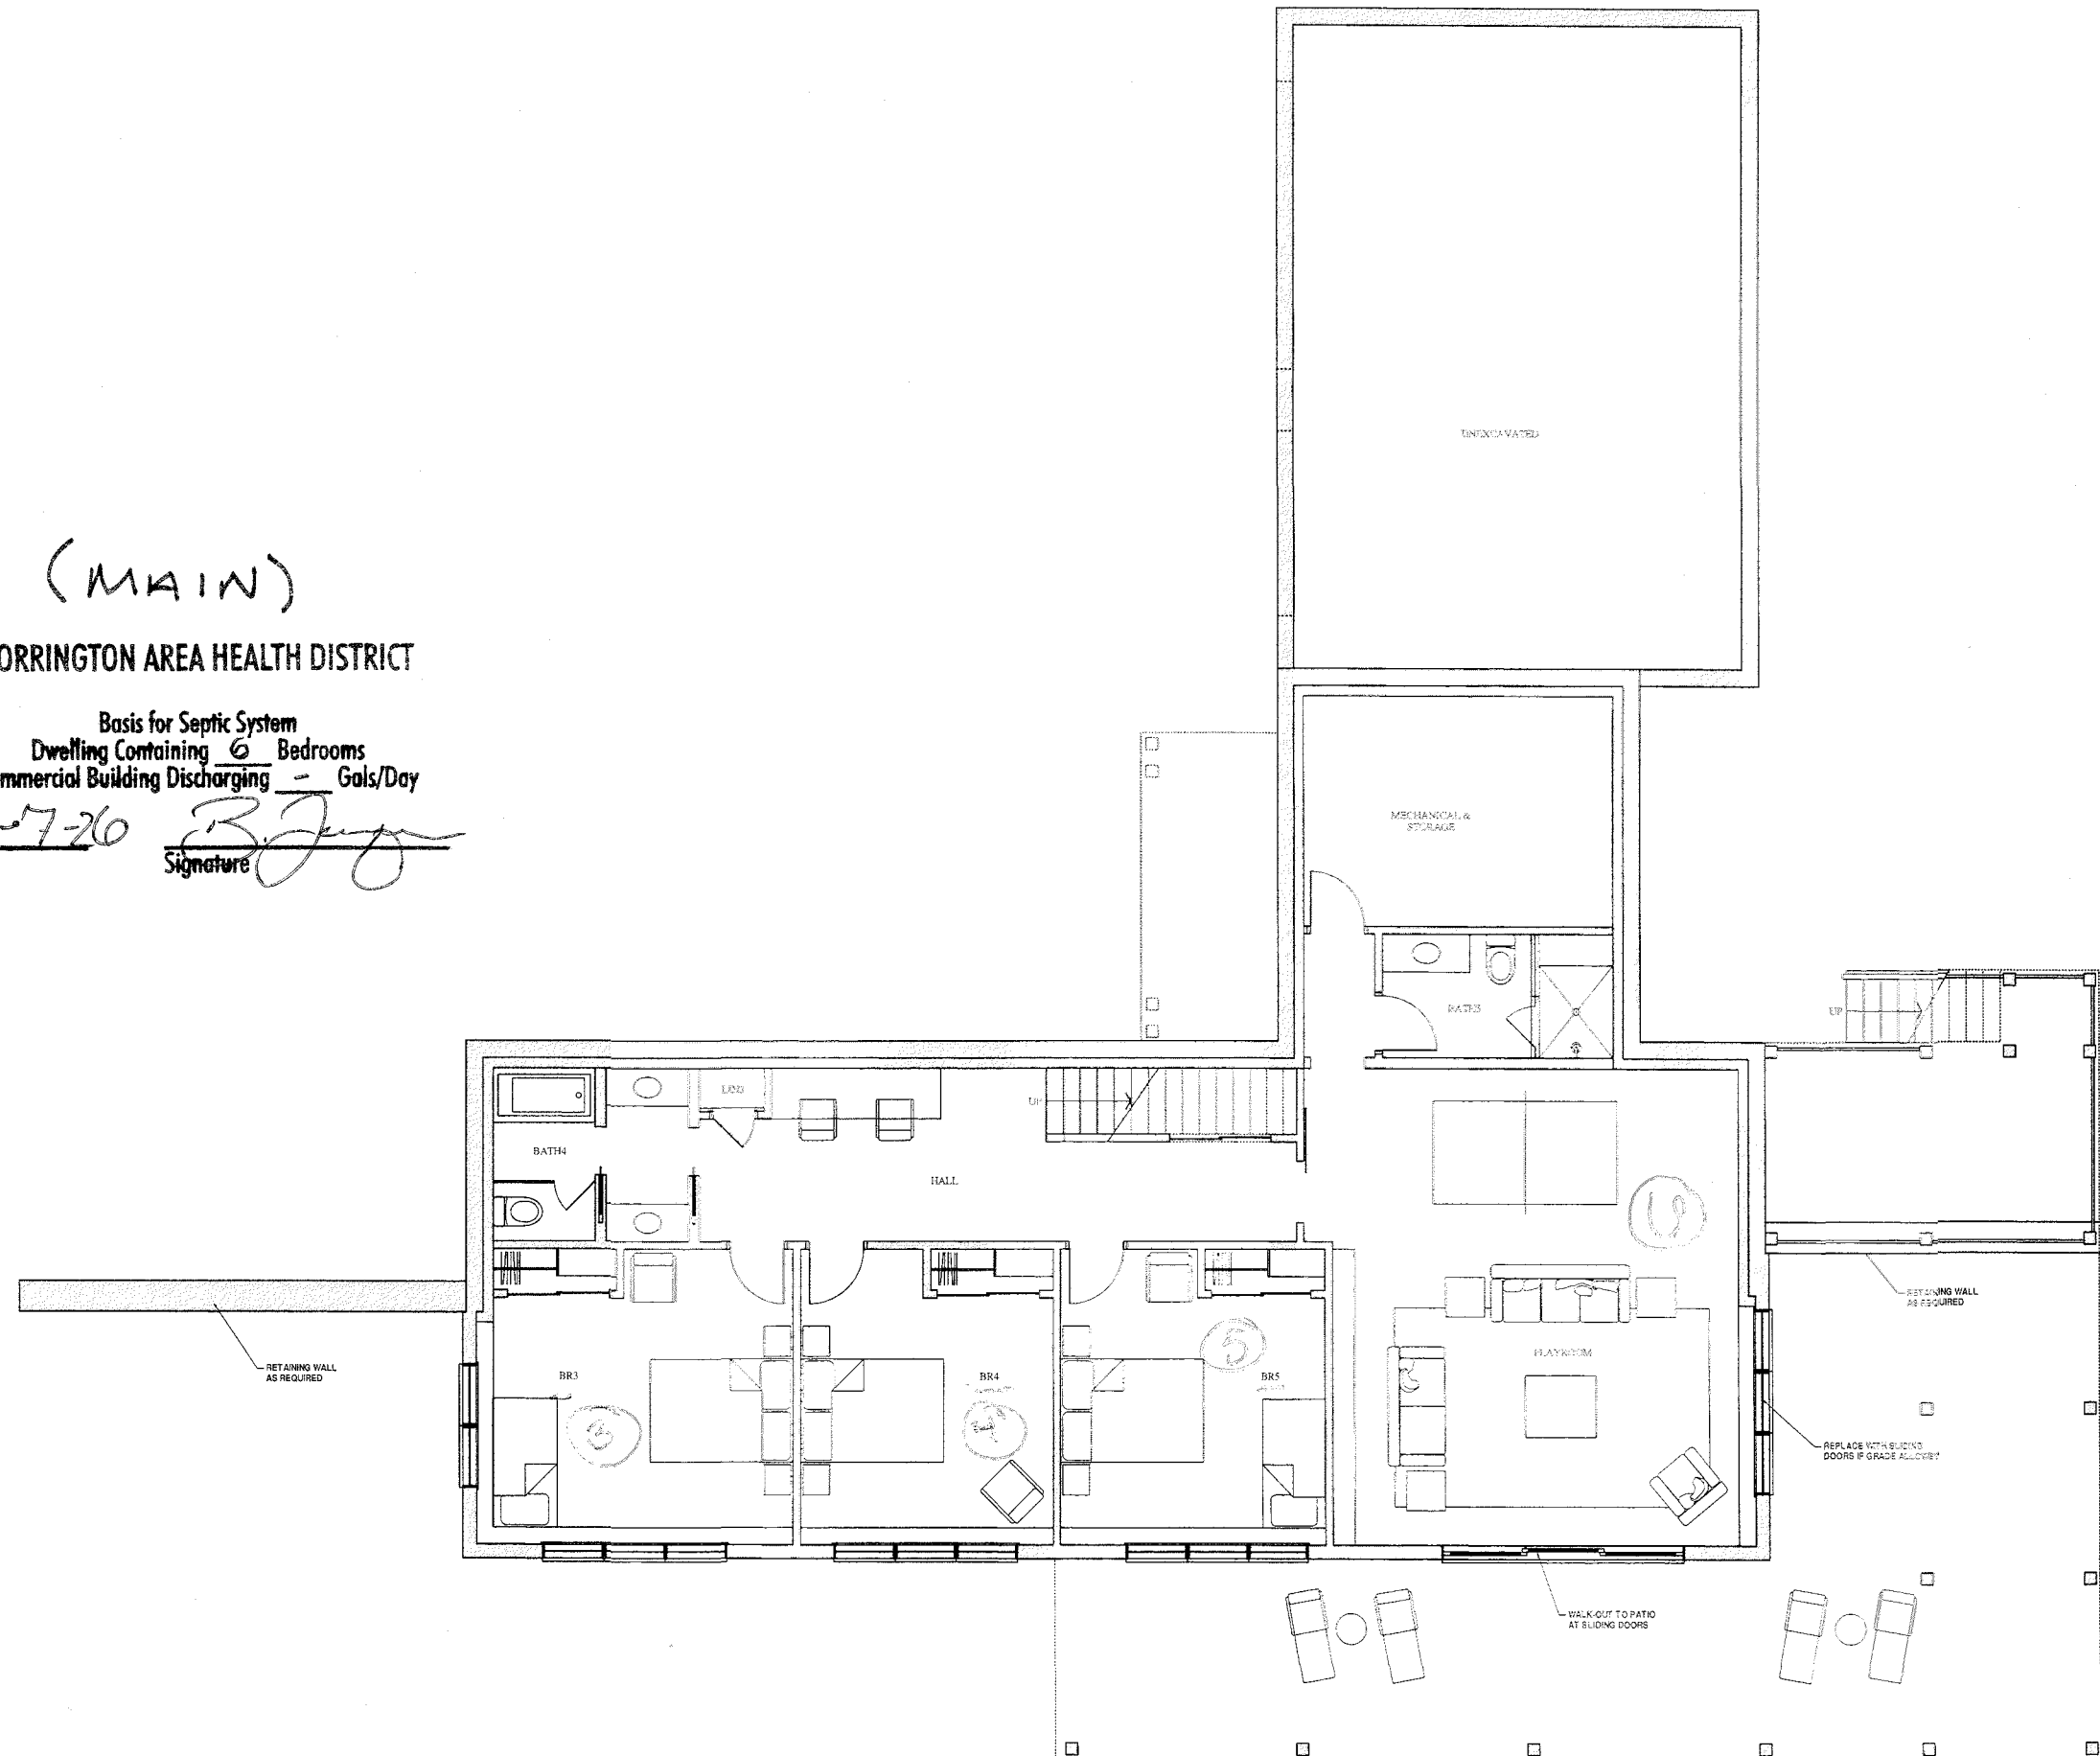

Revisions		
No.	Date	Description

PROPOSED DESIGN FOR
BRAVIN RESIDENCE & GUESTHOUSE
62 ROCKY LANE, TACONIC, CT

Elizabeth Slotnick
Architect
16 PROSPECT STREET
LAKEVILLE, CT 06039
860 435-1403
abelslotnick@gmail.com

Signature and Seal
Professional License #: CT-ARI 9437
See Information

SCHEMATIC
DESIGN III

NOT FOR
CONSTRUCTION

Sheet Title

LOWER LEVEL
FLOOR PLAN

Date 04-03-26
Scale 1/4" = 1'-0"
Project No. BR26
Sheet No. A-2


TORRINGTON AREA HEALTH DISTRICT

Basis for Septic System
Dwelling Containing 3 Bedrooms
Commercial Building Discharging — Gals/Day

7-7-26
Date

[Signature]
Signature

(GUEST)

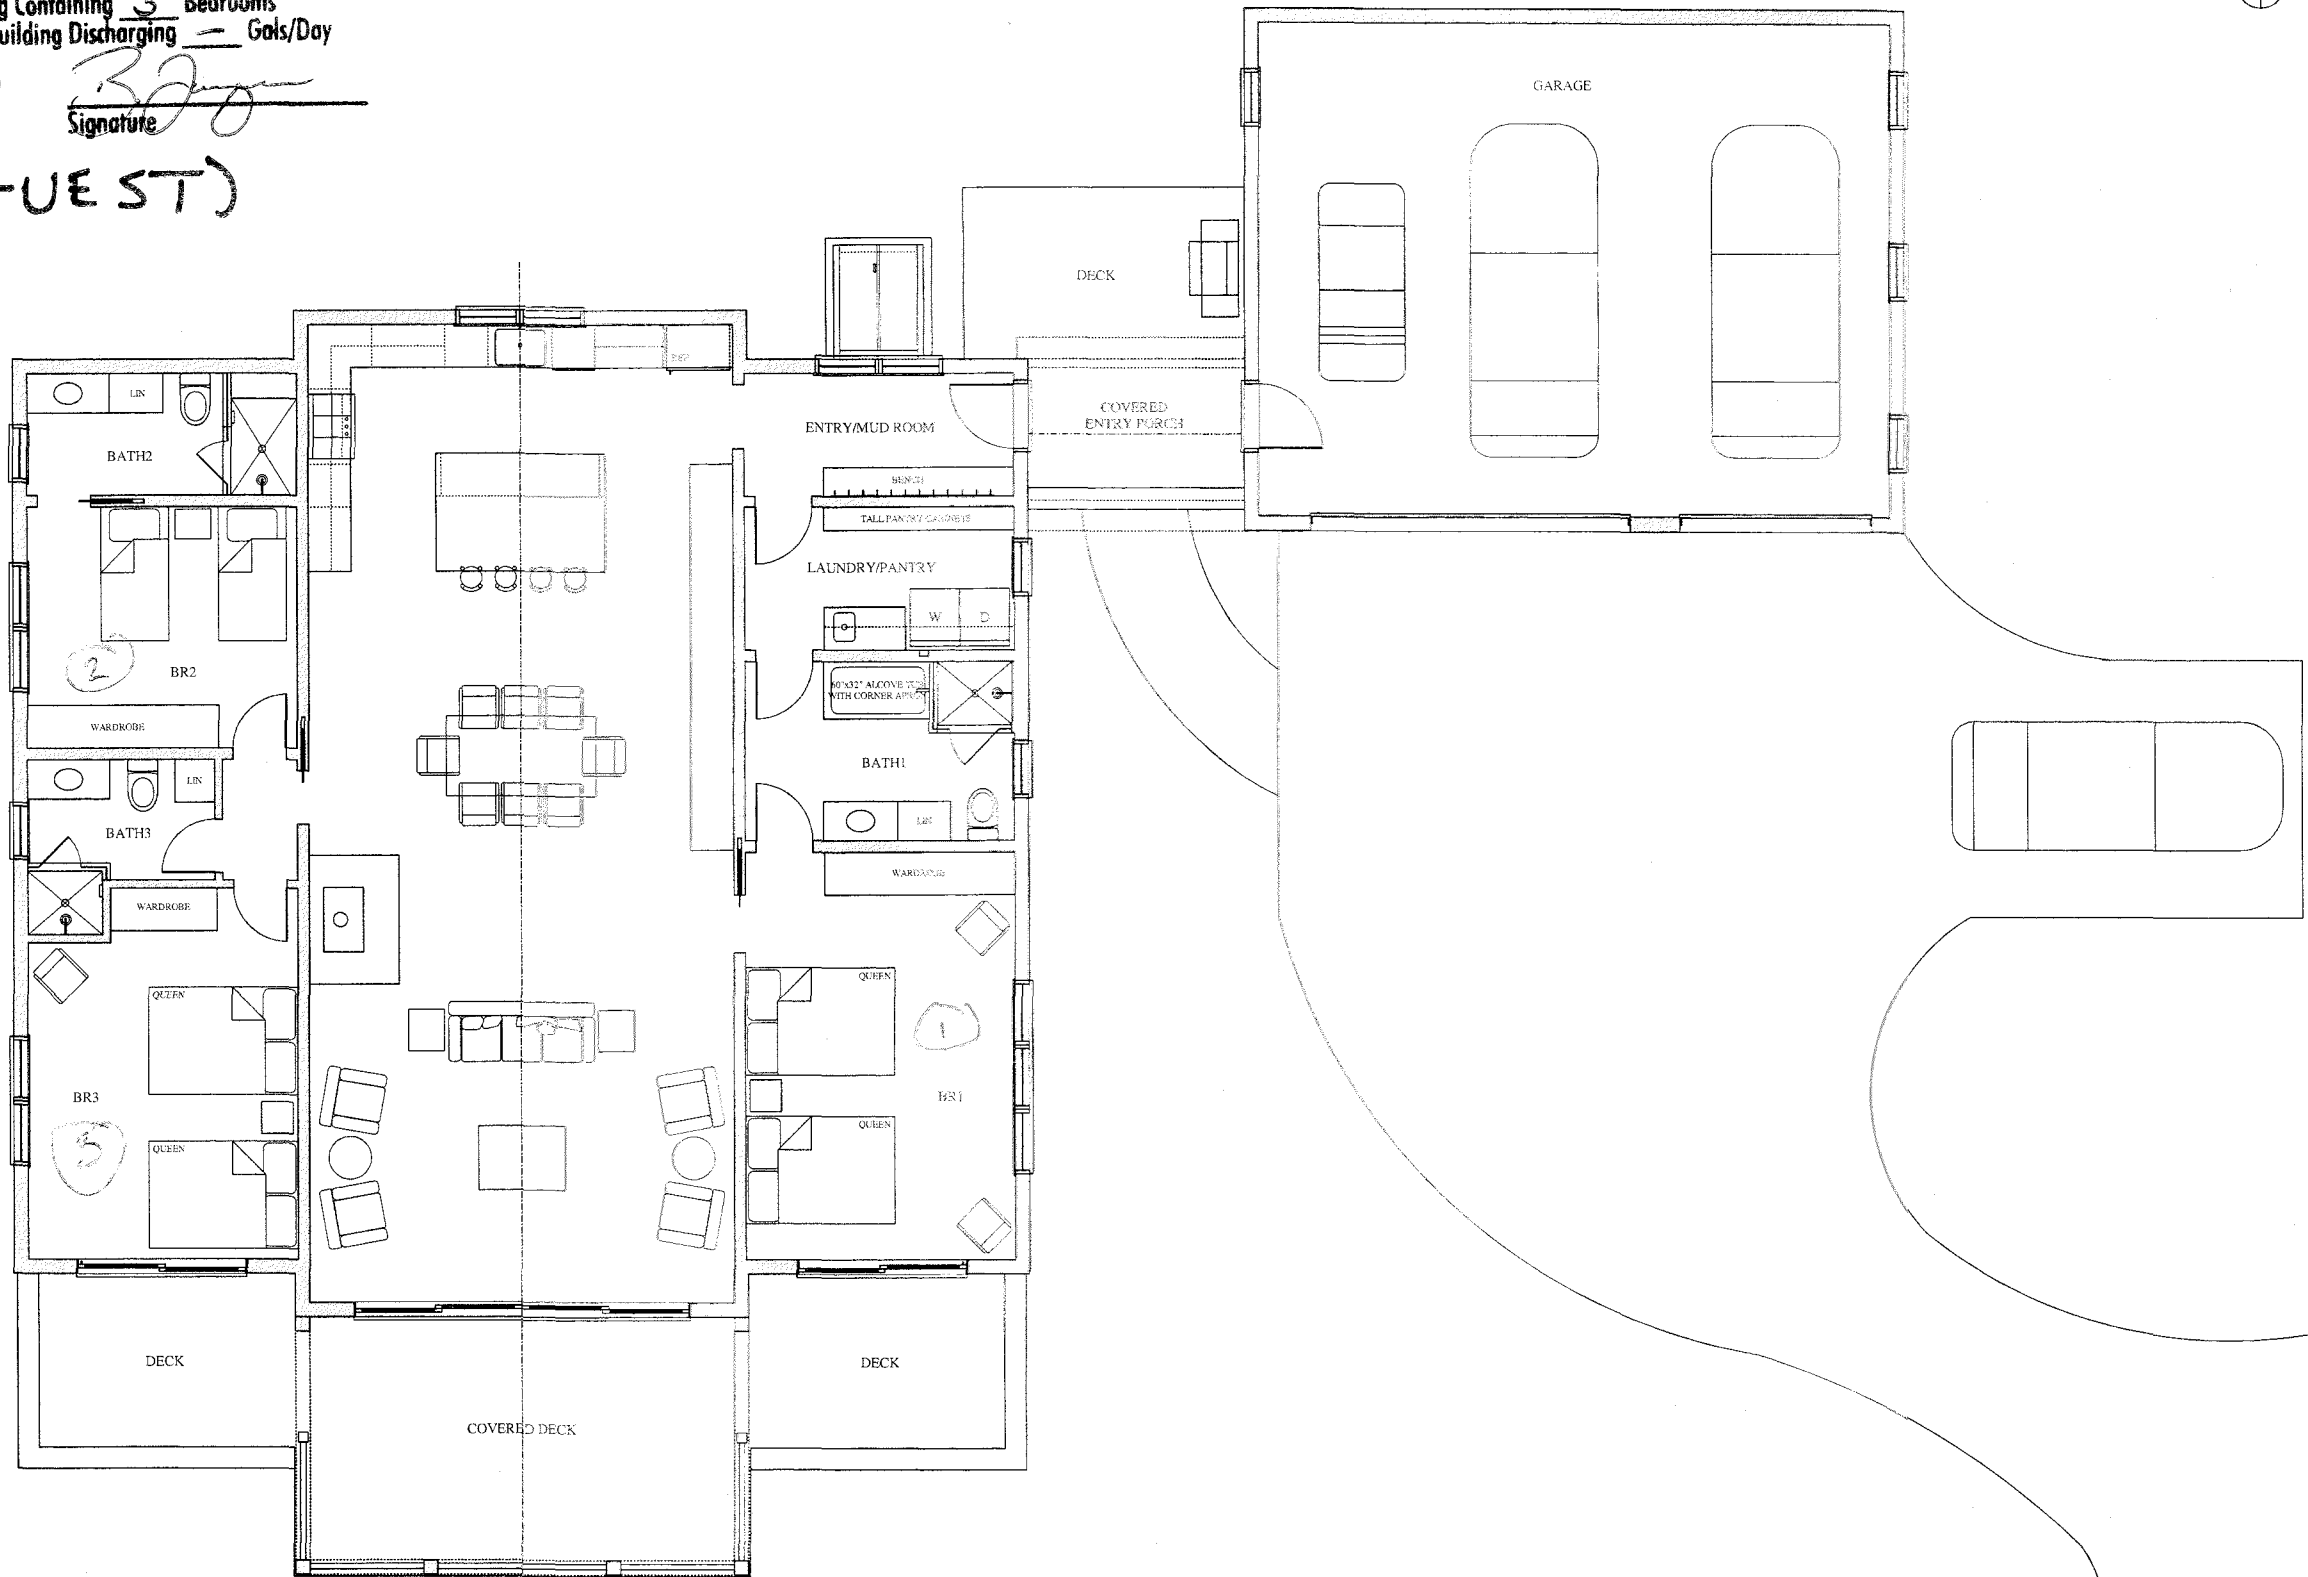

Revisions		
No.	Date	Description

PROPOSED DESIGN FOR
BRAVIN RESIDENCE & GUESTHOUSE
62 ROCKY LANE, TACONIC, CT

Elizabeth Slotnick
Architect
16 PROSPECT STREET
LAKEVILLE, CT 06039
860 435-1403
abelslotnick@gmail.com

Signature and Seal:
Professional License #: CT-AR19437
Set Information

SCHEMATIC
DESIGN III
NOT FOR
CONSTRUCTION

Sheet Title
GUESTHOUSE
MAIN LEVEL
FLOOR PLAN

Date: 04-03-26
Scale: 1/4" = 1'-0"
Project No.: BR26
Sheet No.: G-1